LINE LEGEND

- MAIN PROCESS LINE (POTABLE WATER)
- PROCESS BRANCH LINE
- SERVICE WATER / UTILITY WATER
- CHEMICAL / DISINFECTANT
- COMPRESSED AIR
- DRAINAGE / OVERFLOW
- COOLING WATER LOOP
- FUTURE
- MEASUREMENT / SIGNAL
- BATTERY LIMIT / SCOPE INTERFACE
- VENDOR PACKAGE BOUNDARY (PU)

LINE CONNECTIONS

CONNECTED

NOT CONNECTED

PER W-G-SS-017 REV 0
CL. 5.7.1 AND 5.7.2

EQUIPMENT SYMBOLS

- STORAGE TANK
- VESSEL / SURGE VESSEL / RECEIVER
- CENTRIFUGAL PUMP WITH ELECTRIC MOTOR (VFD WHERE NOTED) — M
- BLADDER TYPE SURGE VESSEL
- COMPRESSOR / BLOWER
- HEAT EXCHANGER / CHILLER
- TAG — PACKAGED EQUIPMENT ITEM
- PIT / SUMP / LAGOON
- FUTURE EQUIPMENT (DASHED OUTLINE)

ABBREVIATIONS

AIT	ANALYSER INDICATING TRANSMITTER	**MOV**	MOTOR OPERATED VALVE
B.L.	BATTERY LIMIT	**NAOCL**	SODIUM HYPOCHLORITE
DWG	DRAWING	**NC / NO**	NORMALLY CLOSED / OPEN
FCV	FLOW CONTROL VALVE	**NTS**	NOT TO SCALE
FE	FLOW ELEMENT	**P&ID**	PIPING AND INSTRUMENTATION DIAGRAM
FIT	FLOW INDICATING TRANSMITTER	**PU**	PACKAGE UNIT
HCL	HYDROCHLORIC ACID	**SP**	SAMPLING POINT
HX	HEAT EXCHANGER	**SV**	SURGE VESSEL
IP	INJECTION POINT	**TYP.**	TYPICAL
LIT	LEVEL INDICATING TRANSMITTER	**VFD**	VARIABLE FREQUENCY DRIVE
MIG	MILLION IMPERIAL GALLONS (VOLUME)	**WQM**	WATER QUALITY MONITORING
MIGD	MILLION IMPERIAL GALLONS PER DAY (FLOW)		

VALVES, INSTRUMENTS AND MARKERS

- ISOLATION VALVE
- MOTORIZED ISOLATION VALVE — M
- MOTORIZED VALVE, NORMALLY CLOSED (NC) — M
- FLOW CONTROL VALVE
- NON-RETURN VALVE
- FLOW ELEMENT (FLOW METER)
- INSTRUMENT (FUNCTION / NUMBER) — FIT 101
- SAMPLING POINT — SP
- INJECTION POINT
- STREAM NUMBER (SEE STREAM DATA) — S-01
- OFF-SHEET CONNECTOR — SERVICE / FROM / TO / DWG NO., ZONE
- BATTERY LIMIT (B.L.) — B.L.
- VENDOR PACKAGE UNIT — PU
- VARIABLE FREQUENCY DRIVE — VFD

STATION FLOW BALANCE, REFERENCE CASE

	STREAM	DESCRIPTION	MIGD	M3/H
IN	S-01	INCOMING SUPPLY	200	37,884
OUT	S-13	GROUP A OUTLET, TRANSMISSION	150	28,413
OUT	S-23	GROUP B OUTLET, DISTRIBUTION	50	9,471
		TOTAL OUT	200	37,884

DESIGN BASIS, BAND 3 STANDARDIZED STATION

PARAMETER	VALUE
FLOW BANDS	BAND 1 UP TO 50 MIGD; BAND 2 ABOVE 50 UP TO 100 MIGD; BAND 3 ABOVE 100 UP TO 200 MIGD
REFERENCE CASE	200 MIGD = 37,884 M3/H
PUMP MODULE	25 MIGD = 4,735.5 M3/H
TRANSMISSION GROUP	70 % TO 75 % OF STATION CAPACITY, 250 M HEAD BAND
DISTRIBUTION GROUP	25 % TO 30 % OF STATION CAPACITY, 100 M TO 160 M HEAD BAND
PUMP GROUPS	PHYSICALLY SEPARATE IN ONE PUMP HALL, WITH SEGREGATED DISCHARGE HEADERS
STANDBY AND FUTURE	ONE STANDBY PUMP AND ONE FUTURE PUMP BAY PER GROUP
STORAGE	MINIMUM TWO TANKS PER STATION; REFERENCE CASE 8 X 25 MIG; MINIMUM 24 H AT RATED FLOW
SURGE PROTECTION	SUCTION AND DISCHARGE SIDES
COMPRESSED AIR	FOR THE DISCHARGE SURGE VESSELS, PER W-M-SS-007 REV 2
DISINFECTION	ON-SITE SODIUM HYPOCHLORITE GENERATION, INJECTION AT THE DISCHARGE HEADERS

BAND 3 SCALABILITY, 25 MIGD MODULE EXAMPLE

STATION FLOW (MIGD)	100	125	150	175	200
25 MIG TANKS	4	5	6	7	8
25 MIGD DUTY PUMPS	4	5	6	7	8

SHEET INDEX

DRAWING NO.	TITLE
N-19082-RO-012-TQT-AES-PFD-B3-001	LEGEND, DESIGN BASIS AND GENERAL NOTES
N-19082-RO-012-TQT-AES-PFD-B3-002	STATION INLET AND STORAGE
N-19082-RO-012-TQT-AES-PFD-B3-003	MAIN PUMPING, SURGE PROTECTION AND OUTLETS
N-19082-RO-012-TQT-AES-PFD-B3-004	DISINFECTION SYSTEM
N-19082-RO-012-TQT-AES-PFD-B3-005	COMPRESSED AIR, SERVICE WATER, COOLING AND DRAINAGE

NOTES:

1. THIS PFD SHOWS THE STANDARDIZED PROCESS ARRANGEMENT FOR THE BAND 3 PUMPING STATION, BASED ON THE 200 MIGD REFERENCE CASE. EQUIPMENT QUANTITIES, CAPACITIES, SIZES AND RATINGS ARE ESTABLISHED FOR EACH PROJECT DURING DETAILED DESIGN. THE NUMBER OF PUMPS, PUMP MODULE SIZE (5, 10 OR 25 MIGD) AND TRANSMISSION / DISTRIBUTION SPLIT ARE SELECTED IN ACCORDANCE WITH THE STANDARDIZATION STUDY FOR MAIN TRANSMISSION AND DISTRIBUTION PUMPS.
2. MIGD IS USED FOR FLOW AND MIG FOR STORAGE VOLUME; 1 MIGD = 4,546.09 M3/DAY.
3. LINE SIZES, PRESSURE RATINGS, VALVE TYPES, INSTRUMENT LOOPS AND INTERLOCKS ARE SHOWN ON THE P&IDS, WHICH SHALL BE CONSISTENT WITH THIS PFD (W-G-SS-017 REV 0, CL. 4.2.6 AND 6.1.2).
4. THE SAME PROCESS ARRANGEMENT SERVES THE WHOLE BAND 3 RANGE. PUMP MODULES AND STORAGE TANKS ARE ADDED IN STEPS.
5. ONE FUTURE PUMP BAY IS PROVIDED IN EACH PUMP GROUP.
6. EQUIPMENT AND INSTRUMENT NUMBERS ARE FUNCTIONAL NUMBERS FOR THIS STANDARD DESIGN.
7. BUILDINGS, ROOMS AND NON-PROCESS FACILITIES ARE SHOWN ON THE SITE LAYOUT AND BUILDING SCHEDULES. ELECTRICAL SUPPLY, EMERGENCY GENERATION, FIRE PROTECTION AND BUILDING HVAC ARE COVERED BY THE RESPECTIVE DISCIPLINE DOCUMENTS; ONLY THEIR PROCESS INTERFACES ARE SHOWN.

REFERENCE DRAWINGS / DOCUMENTS:

DOCUMENT NO.	TITLE
W-G-SS-017 REV 0	TQT P&ID SPECIFICATION
N14054-TYP-E-407 REV 0	TQT GUIDELINE TYPICAL PS P&IDS, SHEETS 2 TO 7
W-M-SS-007 REV 2	AIR COMPRESSOR PACKAGE FOR SURGE VESSELS

REV	DATE	DESCRIPTION	DRN	CHK	APP
0	OCT 2026	ISSUED FOR REVIEW			

CLIENT:

TAQA TRANSMISSION

CONSULTANT:

DR. MAHMOOD ALI AL SAIE ENGINEERING CONSULTANCY AND DESIGN BUREAU (AES)

MAIN CONTRACTOR: NOT APPLICABLE (STANDARD DESIGN)

PROJECT:

CONTRACT N-19082-RO-012: DESIGN STANDARDIZATION FOR PUMPING STATIONS AND PIPELINE NETWORK

DRAWING TITLE:

PROCESS FLOW DIAGRAM

STANDARDIZED PUMPING STATION, BAND 3 (200 MIGD)

LEGEND, DESIGN BASIS AND GENERAL NOTES

SCALE:	SIZE:	SHEET:	STATUS:
NTS	A0	1 OF 5	ISSUED FOR REVIEW

DRAWING NO.: **N-19082-RO-012-TQT-AES-PFD-B3-001**


REV: **0**

STATION INLET

INCOMING SUPPLY LINES (TYP.) WITH INLET ISOLATION, FLOW CONTROL AND FLOW METERING AT THE PIPELINE NETWORK INTERFACE.
WQM-101: INLET WATER QUALITY MONITORING.

T-101 TO T-108 POTABLE WATER STORAGE TANKS

REFERENCE CASE: 8 TANKS OF 25 MIG EACH. MINIMUM OF TWO TANKS PER STATION. STORAGE FOR A MINIMUM OF 24 H AT RATED FLOW. OVERFLOW AND DRAIN FROM EACH TANK TO OVERFLOW PIT OP-101.
TANK OUTLET MANIFOLD IN THREE SECTIONS; EACH SECTION FEEDS ONE SUCTION HEADER SECTION (DWG B3-003).

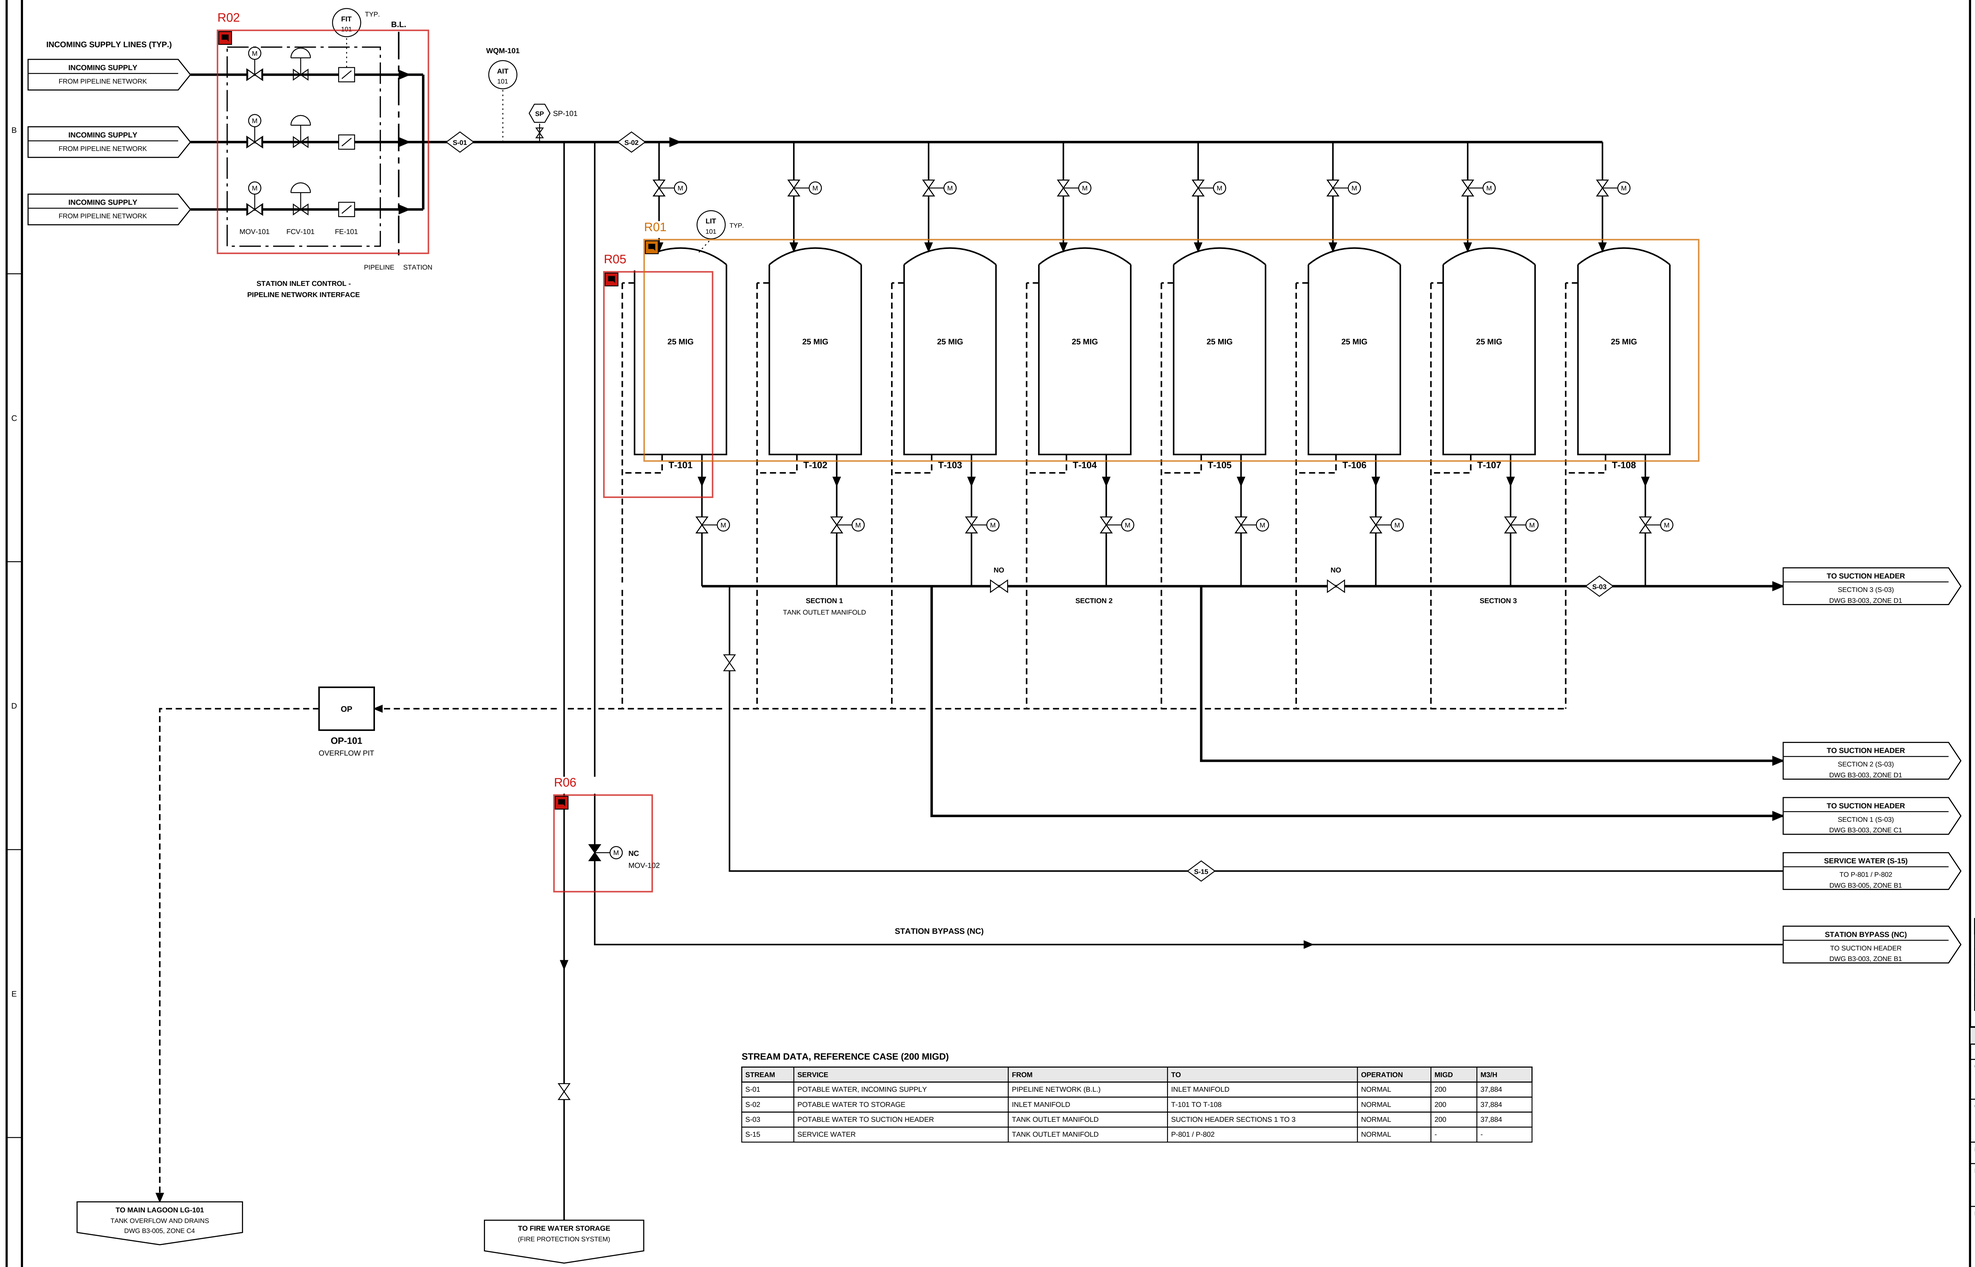

STREAM DATA, REFERENCE CASE (200 MIGD)

STREAM	SERVICE	FROM	TO	OPERATION	MIGD	M3/H
S-01	POTABLE WATER, INCOMING SUPPLY	PIPELINE NETWORK (B.L.)	INLET MANIFOLD	NORMAL	200	37,884
S-02	POTABLE WATER TO STORAGE	INLET MANIFOLD	T-101 TO T-108	NORMAL	200	37,884
S-03	POTABLE WATER TO SUCTION HEADER	TANK OUTLET MANIFOLD	SUCTION HEADER SECTIONS 1 TO 3	NORMAL	200	37,884
S-15	SERVICE WATER	TANK OUTLET MANIFOLD	P-801 / P-802	NORMAL	-	-

NOTES:

1. TANK OVERFLOWS AND DRAINS DISCHARGE THROUGH OVERFLOW PIT OP-101 TO THE MAIN LAGOON LG-101 (DWG B3-005).
2. A MINIMUM OF TWO TANKS IS PROVIDED AT EACH STATION SO THAT THE LOSS OF ONE TANK DOES NOT STOP THE STATION.
3. THE STATION BYPASS IS NORMALLY CLOSED.
4. THE STATION INLET CONTROL (ISOLATION, FLOW CONTROL AND FLOW METERING) IS THE INTERFACE WITH THE PIPELINE NETWORK.

REFERENCE DRAWINGS / DOCUMENTS:

DOCUMENT NO.	TITLE
N-19082-RO-012-TQT-AES-PFD-B3-001	LEGEND, DESIGN BASIS AND GENERAL NOTES
N-19082-RO-012-TQT-AES-PFD-B3-003	MAIN PUMPING, SURGE PROTECTION AND OUTLETS
N-19082-RO-012-TQT-AES-PFD-B3-005	COMPRESSED AIR, SERVICE WATER, COOLING, DRAINAGE
N14054-TYP-E-407 SH 2, 3	TQT GUIDELINE P&ID: INLET, TANK FARM
W-G-SS-017 REV 0	TQT P&ID SPECIFICATION

REV	DATE	DESCRIPTION	DRN	CHK	APP
0	OCT 2026	ISSUED FOR REVIEW			

CLIENT:

TAQA TRANSMISSION

CONSULTANT:

DR. MAHMOOD ALI AL SAIE ENGINEERING CONSULTANCY AND DESIGN BUREAU (AES)

MAIN CONTRACTOR: NOT APPLICABLE (STANDARD DESIGN)

PROJECT:

CONTRACT N-19082-RO-012: DESIGN STANDARDIZATION FOR PUMPING STATIONS AND PIPELINE NETWORK

DRAWING TITLE:

PROCESS FLOW DIAGRAM

STANDARDIZED PUMPING STATION, BAND 3 (200 MIGD)

STATION INLET AND STORAGE

SCALE:	SIZE:	SHEET:	STATUS:
NTS	A0	2 OF 5	ISSUED FOR REVIEW

DRAWING NO.: **N-19082-RO-012-TQT-AES-PFD-B3-002**

REV: **0**

SUCTION HEADER

ONE SUCTION HEADER IN THREE SECTIONS WITH TWO NORMALLY OPEN SECTIONING VALVES. EACH SECTION IS FED BY ITS OWN TANK OUTLET LINE AND SERVES PUMPS OF BOTH GROUPS.

MAIN PUMPS


GROUP A: TRANSMISSION, HEAD BAND 250 M. GROUP B: DISTRIBUTION, HEAD BAND 100 M TO 160 M. ONE STANDBY PUMP AND ONE FUTURE PUMP BAY PER GROUP. PUMPS WITH VFD.

SURGE PROTECTION

SUCTION SURGE VESSELS ON EACH SUCTION HEADER SECTION. DISCHARGE SURGE VESSELS ON EACH DISCHARGE HEADER, ON THE COMPRESSED-AIR MAIN (W-M-SS-007 REV 2).

GROUP OUTLETS

FLOW METERING, DISINFECTANT INJECTION, SAMPLING, WATER QUALITY MONITORING, FLOW CONTROL WITH BYPASS AND MOTORIZED ISOLATION.

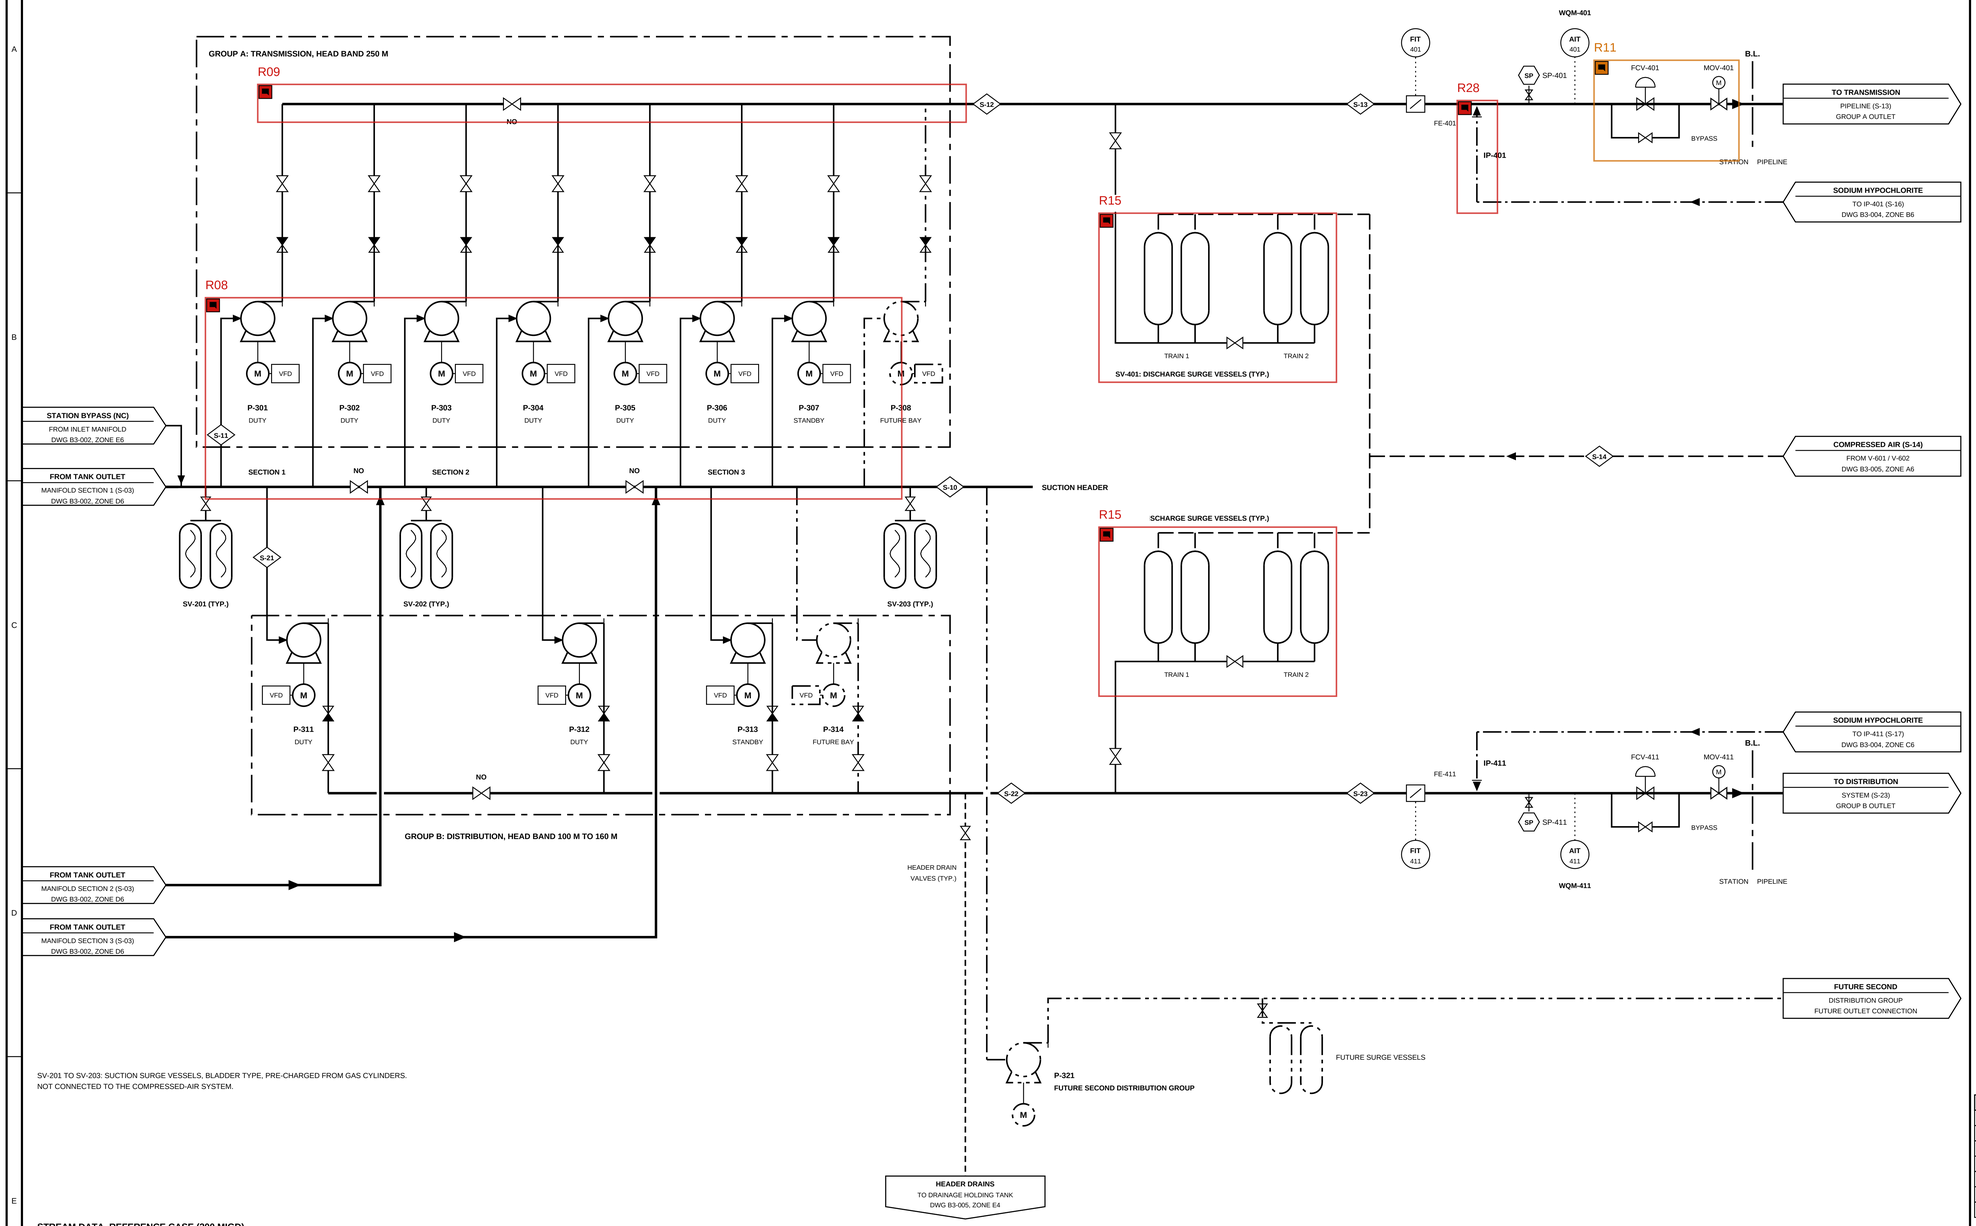

SV-201 TO SV-203: SUCTION SURGE VESSELS, BLADDER TYPE, PRE-CHARGED FROM GAS CYLINDERS.
NOT CONNECTED TO THE COMPRESSED-AIR SYSTEM.

STREAM DATA, REFERENCE CASE (200 MIGD)

STREAM	SERVICE	FROM	TO	OPERATION	MIGD	M3/H
S-03	POTABLE WATER TO SUCTION HEADER	TANK OUTLET MANIFOLD	SUCTION HEADER SECTIONS 1 TO 3	NORMAL	200	37,884
S-10	SUCTION HEADER	S-03	PUMP GROUPS A AND B	NORMAL	200	37,884
S-11	GROUP A SUCTION	SUCTION HEADER	P-301 TO P-308	NORMAL	150	28,413
S-12	GROUP A DISCHARGE HEADER	P-301 TO P-308	GROUP A OUTLET	NORMAL	150	28,413
S-13	GROUP A OUTLET, TRANSMISSION	GROUP A OUTLET	TRANSMISSION PIPELINE (B.L.)	NORMAL	150	28,413
S-21	GROUP B SUCTION	SUCTION HEADER	P-311 TO P-314	NORMAL	50	9,471
S-22	GROUP B DISCHARGE HEADER	P-311 TO P-314	GROUP B OUTLET	NORMAL	50	9,471
S-23	GROUP B OUTLET, DISTRIBUTION	GROUP B OUTLET	DISTRIBUTION SYSTEM (B.L.)	NORMAL	50	9,471
S-14	COMPRESSED AIR	V-601 / V-602	DISCHARGE SURGE VESSELS	NORMAL	-	-
S-16	SODIUM HYPOCHLORITE TO IP-401	P-506	IP-401, GROUP A OUTLET	NORMAL	-	-
S-17	SODIUM HYPOCHLORITE TO IP-411	P-506	IP-411, GROUP B OUTLET	NORMAL	-	-

NOTES:

1. PUMP GROUPS A AND B ARE PHYSICALLY SEPARATE WITHIN ONE PUMP HALL. EACH GROUP HAS A SEGREGATED DISCHARGE HEADER.
2. THE SUCTION AND DISCHARGE HEADER SECTIONING VALVES ARE NORMALLY OPEN. WITH ANY ONE SECTION ISOLATED, AT LEAST HALF OF THE DUTY CAPACITY OF EACH GROUP REMAINS IN SERVICE.
3. SUCTION SURGE VESSELS ARE BLADDER TYPE, PRE-CHARGED FROM GAS CYLINDERS, AND ARE NOT CONNECTED TO THE COMPRESSED-AIR SYSTEM.
4. DISCHARGE SURGE VESSELS ARE ARRANGED IN ISOLABLE TRAINS CONNECTED TO THE COMPRESSED-AIR MAIN.
5. PROVISION FOR A SECOND DISTRIBUTION PUMP GROUP WITH SEPARATE DISCHARGE HEADER AND SURGE PROTECTION.

REFERENCE DRAWINGS / DOCUMENTS:

DOCUMENT NO.	TITLE
N-19082-RO-012-TQT-AES-PFD-B3-001	LEGEND, DESIGN BASIS AND GENERAL NOTES
N-19082-RO-012-TQT-AES-PFD-B3-002	STATION INLET AND STORAGE
N-19082-RO-012-TQT-AES-PFD-B3-004	DISINFECTION SYSTEM
N-19082-RO-012-TQT-AES-PFD-B3-005	COMPRESSED AIR, SERVICE WATER, COOLING, DRAINAGE
N14054-TYP-E-407 SH 4, 5, 6	TQT GUIDELINE P&ID: PUMPS, SURGE, DISCHARGE
W-M-SS-007 REV 2	AIR COMPRESSOR PACKAGE FOR SURGE VESSELS
W-G-SS-017 REV 0	TQT P&ID SPECIFICATION

REV	DATE	DESCRIPTION	DRN	CHK	APP
0	OCT 2026	ISSUED FOR REVIEW			

CLIENT:

TAQA TRANSMISSION

CONSULTANT:

DR. MAHMOOD ALI AL SAIE ENGINEERING CONSULTANCY AND DESIGN BUREAU (AES)

MAIN CONTRACTOR: NOT APPLICABLE (STANDARD DESIGN)

PROJECT:

CONTRACT N-19082-RO-012: DESIGN STANDARDIZATION FOR PUMPING STATIONS AND PIPELINE NETWORK

DRAWING TITLE:

PROCESS FLOW DIAGRAM

STANDARDIZED PUMPING STATION, BAND 3 (200 MIGD)

MAIN PUMPING, SURGE PROTECTION AND OUTLETS


SCALE:	SIZE:	SHEET:	STATUS:
NTS	A0	3 OF 5	ISSUED FOR REVIEW

DRAWING NO.: **N-19082-RO-012-TQT-AES-PFD-B3-003**

REV: **0**

X-501 SODIUM HYPOCHLORITE ON-SITE GENERATION

SOFTENED WATER AND BRINE FROM THE SALT SATURATOR ARE ELECTROLYSED TO PRODUCE SODIUM HYPOCHLORITE, WHICH IS STORED AND DOSED TO THE DISCHARGE HEADER INJECTION POINTS IP-401 AND IP-411 (DWG B3-003).

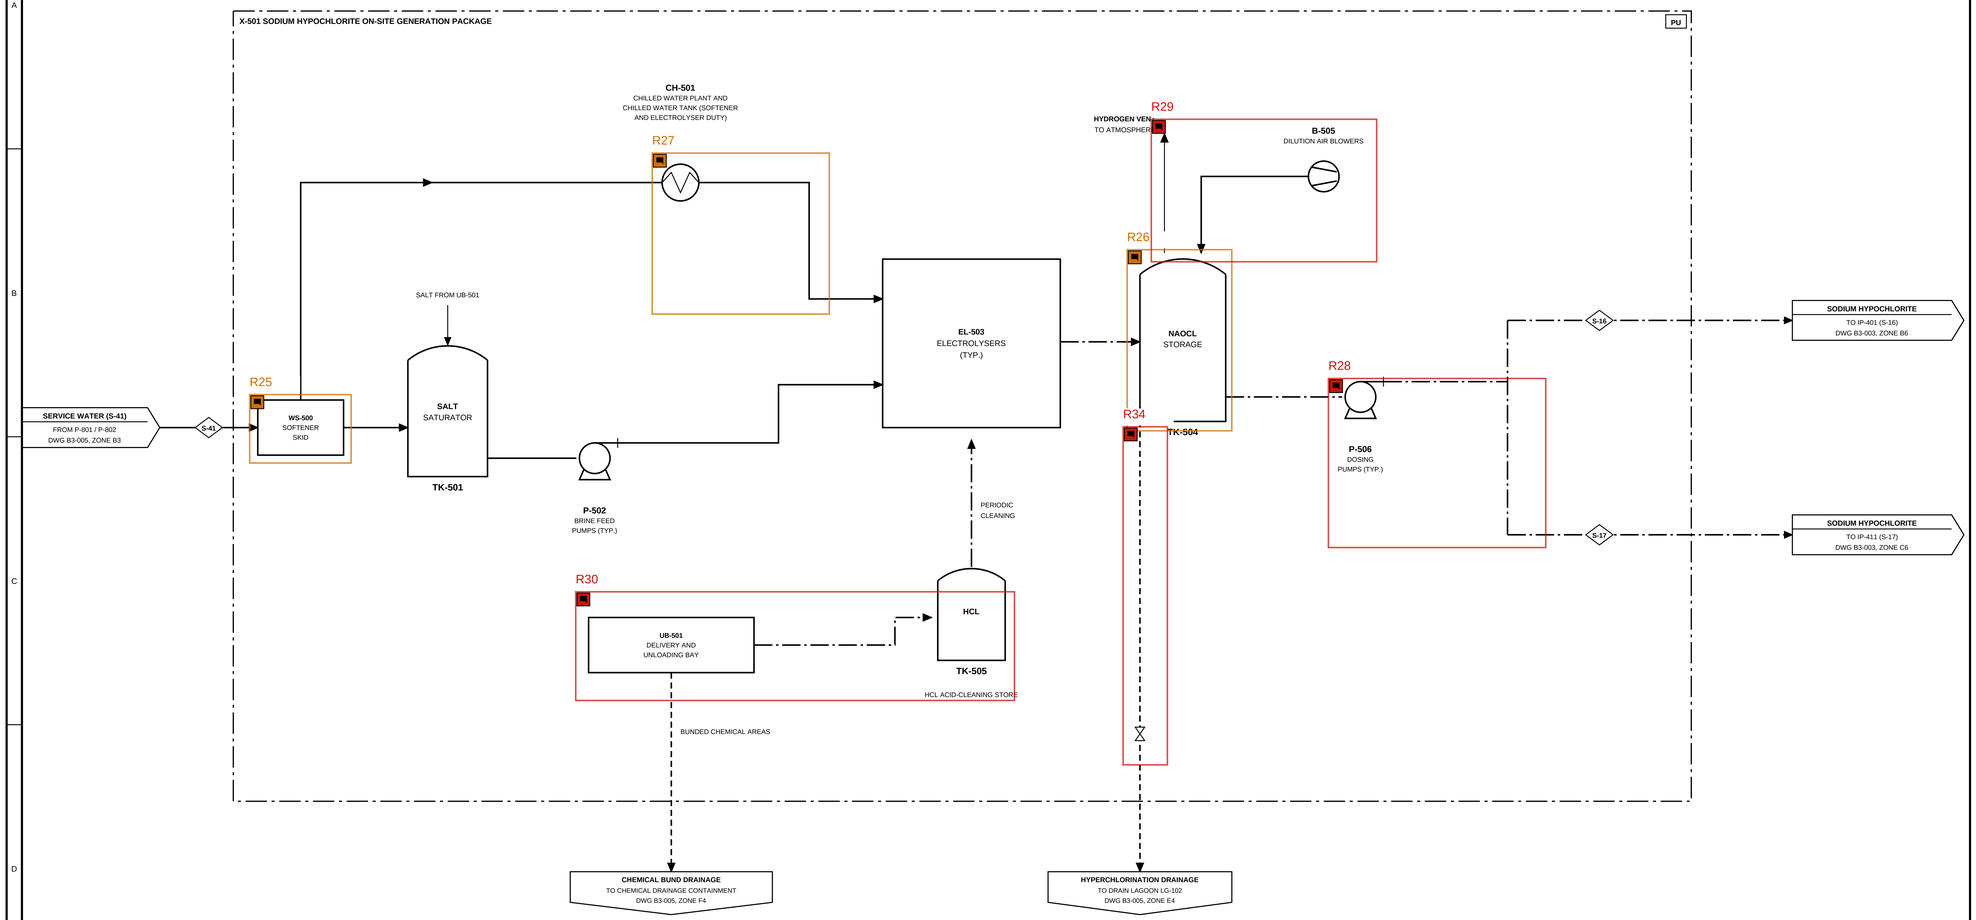

STREAM DATA, REFERENCE CASE (200 MIGD)

STREAM	SERVICE	FROM	TO	MIGD	M3/H
S-16	SODIUM HYPOCHLORITE TO IP-401	P-506	IP-401, GROUP A OUTLET	-	-
S-17	SODIUM HYPOCHLORITE TO IP-411	P-506	IP-411, GROUP B OUTLET	-	-
S-41	SERVICE WATER TO DISINFECTION PACKAGE	P-801 / P-802	WS-500	-	-

NOTES:

1. X-501 SODIUM HYPOCHLORITE ON-SITE GENERATION IS THE BASE-CASE DISINFECTION SYSTEM. CHLORINE DIOXIDE GENERATION IS AN ALTERNATIVE DISINFECTION SYSTEM AND IS NOT INSTALLED TOGETHER WITH SODIUM HYPOCHLORITE GENERATION.
2. SODIUM HYPOCHLORITE IS INJECTED AT THE DISCHARGE HEADERS (IP-401 AND IP-411, DWG B3-003).
3. CH-501 CHILLED WATER PLANT IS DEDICATED TO THE SOFTENER AND ELECTROLYSERS AND IS NOT CONNECTED TO ANY OTHER COOLING SYSTEM.
4. CHEMICAL STORAGE AND UNLOADING AREAS ARE BUNDED. CHEMICAL BUND DRAINAGE IS KEPT SEPARATE FROM CLEAN DRAINAGE.

REFERENCE DRAWINGS / DOCUMENTS:

DOCUMENT NO.	TITLE
N-19082-RO-012-TQT-AES-PFD-B3-001	LEGEND, DESIGN BASIS AND GENERAL NOTES
N-19082-RO-012-TQT-AES-PFD-B3-003	MAIN PUMPING, SURGE PROTECTION AND OUTLETS
N-19082-RO-012-TQT-AES-PFD-B3-005	COMPRESSED AIR, SERVICE WATER, COOLING, DRAINAGE
W-G-SS-017 REV 0	TQT P&ID SPECIFICATION

REV	DATE	DESCRIPTION	DRN	CHK	APP
0	OCT 2026	ISSUED FOR REVIEW			

CLIENT:

TAQA TRANSMISSION

CONSULTANT:

DR. MAHMOOD ALI AL SAIE ENGINEERING CONSULTANCY AND DESIGN BUREAU (AES)

MAIN CONTRACTOR: NOT APPLICABLE (STANDARD DESIGN)

PROJECT:

CONTRACT N-19082-RO-012: DESIGN STANDARDIZATION FOR PUMPING STATIONS AND PIPELINE NETWORK

DRAWING TITLE:

PROCESS FLOW DIAGRAM

STANDARDIZED PUMPING STATION, BAND 3 (200 MIGD)

DISINFECTION SYSTEM

SCALE:	SIZE:	SHEET:	STATUS:
NTS	A0	4 OF 5	ISSUED FOR REVIEW


DRAWING NO.: **N-19082-RO-012-TQT-AES-PFD-B3-004**

REV: **0**


UTILITY SYSTEMS SERVING THE MAIN PROCESS

A. SERVICE WATER. B. COMPRESSED AIR FOR THE DISCHARGE SURGE VESSELS. C. EQUIPMENT COOLING IN THREE SEPARATE SYSTEMS. D. DRAINAGE AND LAGOONS.

A. SERVICE WATER

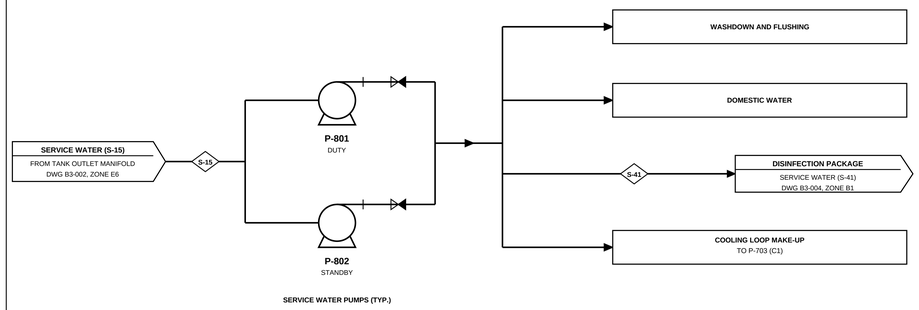


B. COMPRESSED AIR (W-M-SS-007 REV 2)

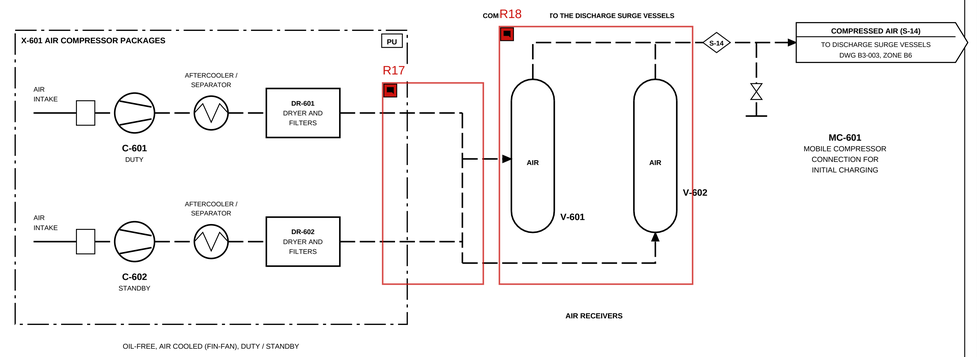


C. EQUIPMENT COOLING: THREE SEPARATE SYSTEMS

C1. PUMP AND MOTOR COOLING - CLOSED LOOP

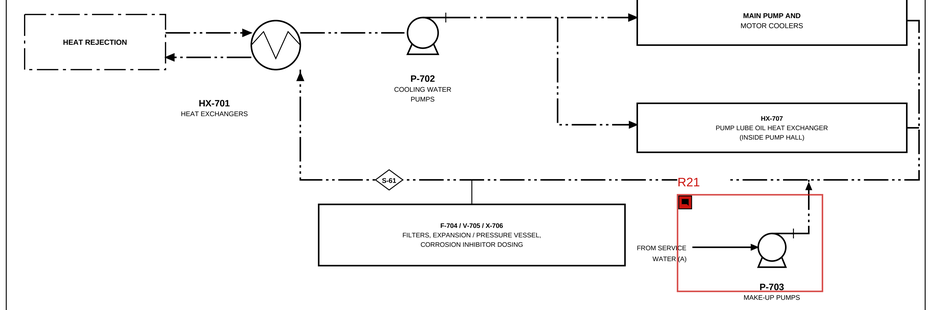

COOLING

R24

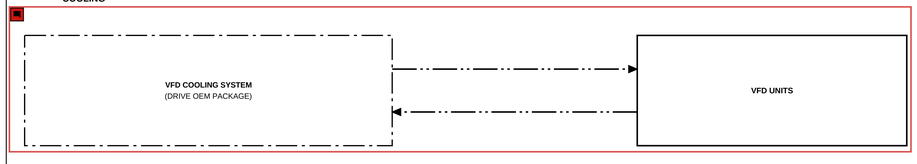


C3. AIR COMPRESSORS - AIR COOLED (FIN-FAN)

C-601 / C-602: AIR COOLED BY FIN-FAN COOLERS. NO WATER CONNECTION.

STREAM DATA, REFERENCE CASE (200 MIGD)

STREAM	SERVICE	FROM	TO	MIGD	M3/H
S-14	COMPRESSED AIR	V-601 / V-602	DISCHARGE SURGE VESSELS	-	-
S-15	SERVICE WATER	TANK OUTLET MANIFOLD	P-801 / P-802	-	-
S-41	SERVICE WATER TO DISINFECTION PACKAGE	P-801 / P-802	WS-500	-	-
S-61	PUMP AND MOTOR COOLING WATER	HX-701	MAIN PUMP AND MOTOR COOLERS	-	-

D. DRAINAGE AND LAGOONS

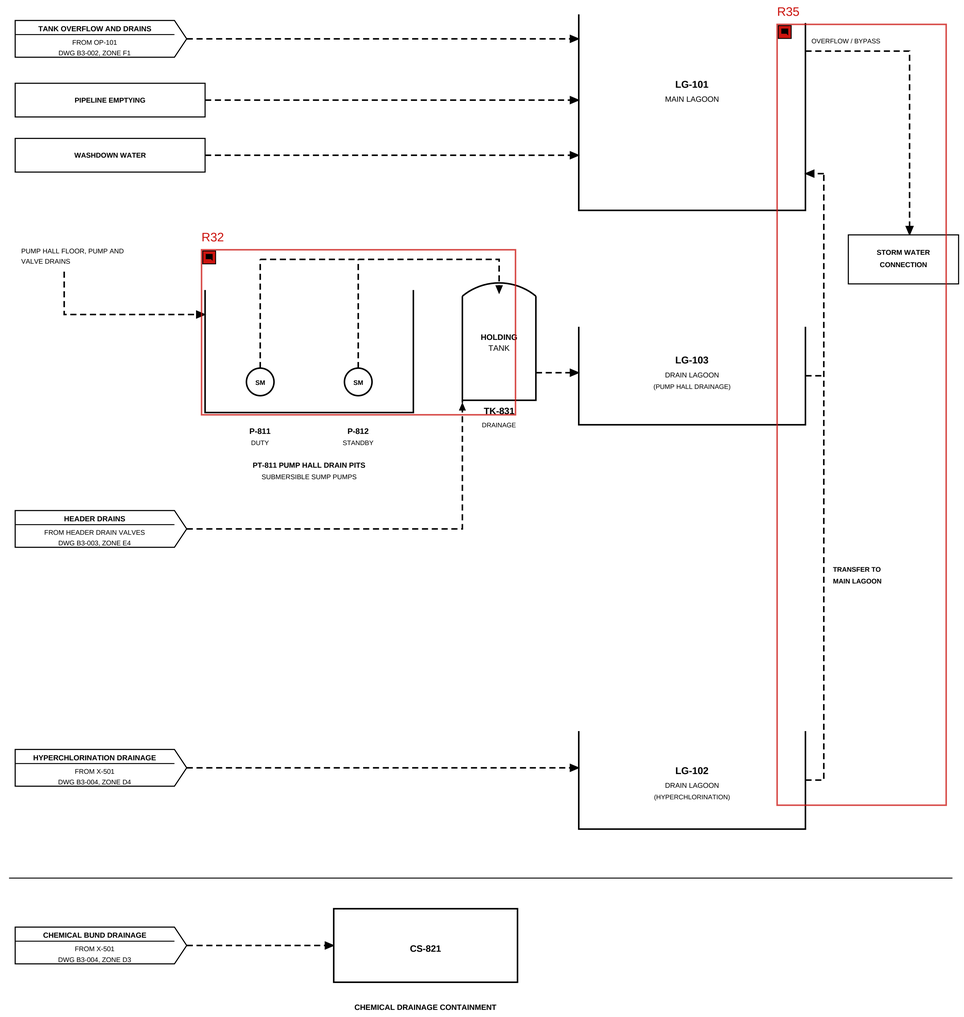

NOTES:

1. THE UTILITY SYSTEMS ARE INDEPENDENT. THERE ARE NO CROSS CONNECTIONS OTHER THAN THE SERVICE WATER SUPPLIES SHOWN.
2. COMPRESSED AIR SERVES THE DISCHARGE SURGE VESSELS ONLY.
3. COOLING SYSTEMS C1, C2 AND C3 ARE SEPARATE SYSTEMS.
4. CHEMICAL DRAINAGE IS CONTAINED AND IS NOT CONNECTED TO CLEAN OR HYPERCHLORINATION DRAINAGE.
5. LAGOONS ARE LOCATED CLOSE TO THE SOURCES THEY SERVE.

REFERENCE DRAWINGS / DOCUMENTS:

DOCUMENT NO.	TITLE
N-19082-RO-012-TQT-AES-PFD-B3-001	LEGEND, DESIGN BASIS AND GENERAL NOTES
N-19082-RO-012-TQT-AES-PFD-B3-002	STATION INLET AND STORAGE
N-19082-RO-012-TQT-AES-PFD-B3-003	MAIN PUMPING, SURGE PROTECTION AND OUTLETS
N-19082-RO-012-TQT-AES-PFD-B3-004	DISINFECTION SYSTEM
W-M-SS-007 REV 2	AIR COMPRESSOR PACKAGE FOR SURGE VESSELS
N14054-TYP-E-407 SH 7	TQT GUIDELINE P&ID: SUMP PUMP
W-G-SS-017 REV 0	TQT P&ID SPECIFICATION

REV	DATE	DESCRIPTION	DRN	CHK	APP
0	OCT 2026	ISSUED FOR REVIEW			

CLIENT:

TAQA TRANSMISSION

CONSULTANT:

DR. MAHMOOD ALI AL SAIE ENGINEERING CONSULTANCY AND DESIGN BUREAU (AES)

MAIN CONTRACTOR: NOT APPLICABLE (STANDARD DESIGN)

PROJECT:

CONTRACT N-19082-RO-012: DESIGN STANDARDIZATION FOR PUMPING STATIONS AND PIPELINE NETWORK

DRAWING TITLE:

PROCESS FLOW DIAGRAM

STANDARDIZED PUMPING STATION, BAND 3 (200 MIGD)
COMPRESSED AIR, SERVICE WATER, COOLING AND DRAINAGE

SCALE:	SIZE:	SHEET:	STATUS:
NTS	A0	5 OF 5	ISSUED FOR REVIEW

DRAWING NO.: **N-19082-RO-012-TQT-AES-PFD-B3-005**

REV: **0**